

DESIGNS BY:

Mark Hofstee

I review and take responsibility
for the design and am qualified
in the appropriate category as
an "other designer" under
sub-section 3.2.5 of the
Ontario Building Code

BCIN: 25513

OWNER'S GENERAL CONTRACTOR
TO VERIFY ALL DIMENSIONS ON SITE
PRIOR TO THE COMMENCEMENT OF
THE WORK. REPORT ANY
DISCREPANCIES TO THE DESIGNER.
DO NOT SCALE DRAWINGS.

PROJECT:

McGILLIVRAY STAHL
RESIDENCE -
2ND FLR. ADDITION

107 ONTARIO ST.
GUELPH, ON

DRAWING TITLE:

PROPOSED
EAST ELEVATION

DATE: 06.FEB.2023

DRAWN BY: TD

STATUS: ISSUED FOR REVIEW

SCALE:

AS NOTED

A5

North



DESIGNS BY:

Mark Hofstee

I review and take responsibility
for the design and am qualified
in the appropriate category as
an "other designer" under
sub-section 3.2.5 of the
Ontario Building Code

BCIN: 25513

OWNER'S GENERAL CONTRACTOR
TO VERIFY ALL DIMENSIONS ON SITE
PRIOR TO THE COMMENCEMENT OF
THE WORK. REPORT ANY
DISCREPANCIES TO THE DESIGNER.
DO NOT SCALE DRAWINGS.

PROJECT:

McGILLIVRAY STAHL
RESIDENCE -
2ND FLR. ADDITION

107 ONTARIO ST.
GUELPH, ON

DRAWING TITLE:

PROPOSED
~~NORTH~~ ELEVATION
West

DATE: 06.FEB.2023

DRAWN BY: TD

STATUS: ISSUED FOR REVIEW

SCALE:

AS NOTED

A6



1
A6

PROPOSED NORTH ELEVATION
SCALE: 1/4" = 1'-0"

DESIGNS BY:

Mark Hofstee

I review and take responsibility
for the design and am qualified
in the appropriate category as
an "other designer" under
sub-section 3.2.5 of the
Ontario Building Code

BCIN: 25513

OWNER'S GENERAL CONTRACTOR
TO VERIFY ALL DIMENSIONS ON SITE
PRIOR TO THE COMMENCEMENT OF
THE WORK. REPORT ANY
DISCREPANCIES TO THE DESIGNER.
DO NOT SCALE DRAWINGS.

PROJECT:

McGILLIVRAY STAHL
RESIDENCE -
2ND FLR. ADDITION

107 ONTARIO ST.
GUELPH, ON

DRAWING TITLE:

PROPOSED
~~WEST~~ ELEVATION

DATE: 06.FEB.2023

DRAWN BY: TD

STATUS: ISSUED FOR REVIEW

SCALE:

AS NOTED

A7





DESIGNS BY:
Mark Hofstee
I review and take responsibility
for the design and am qualified
in the appropriate category as
an "other designer" under
sub-section 3.2.5 of the
Ontario Building Code
BCIN: 25513

OWNER'S GENERAL CONTRACTOR
TO VERIFY ALL DIMENSIONS ON SITE
PRIOR TO THE COMMENCEMENT OF
THE WORK. REPORT ANY
DISCREPANCIES TO THE DESIGNER.
DO NOT SCALE DRAWINGS.

PROJECT:
**McGILLIVRAY STAHL
RESIDENCE -
2ND FLR. ADDITION**

107 ONTARIO ST.
GUELPH, ON

DRAWING TITLE:

**PROPOSED
~~SOUTH~~ ELEVATION
East**

DATE: 06.FEB.2023

DRAWN BY: TD

STATUS: ISSUED FOR REVIEW

SCALE:

AS NOTED **A8**

DESIGNS BY:

Mark Hofstee

I review and take responsibility
for the design and am qualified
in the appropriate category as
an "other designer" under
sub-section 3.2.5 of the
Ontario Building Code

BCIN: 25513

OWNER'S GENERAL CONTRACTOR
TO VERIFY ALL DIMENSIONS ON SITE
PRIOR TO THE COMMENCEMENT OF
THE WORK. REPORT ANY
DISCREPANCIES TO THE DESIGNER.
DO NOT SCALE DRAWINGS.

PROJECT:

McGILLIVRAY STAHL
RESIDENCE -
2ND FLR. ADDITION

107 ONTARIO ST.
GUELPH, ON

DRAWING TITLE:

PROPOSED
SECTION

DATE: 06.FEB.2023


DRAWN BY: TD

STATUS: ISSUED FOR REVIEW

SCALE:

AS NOTED

A9

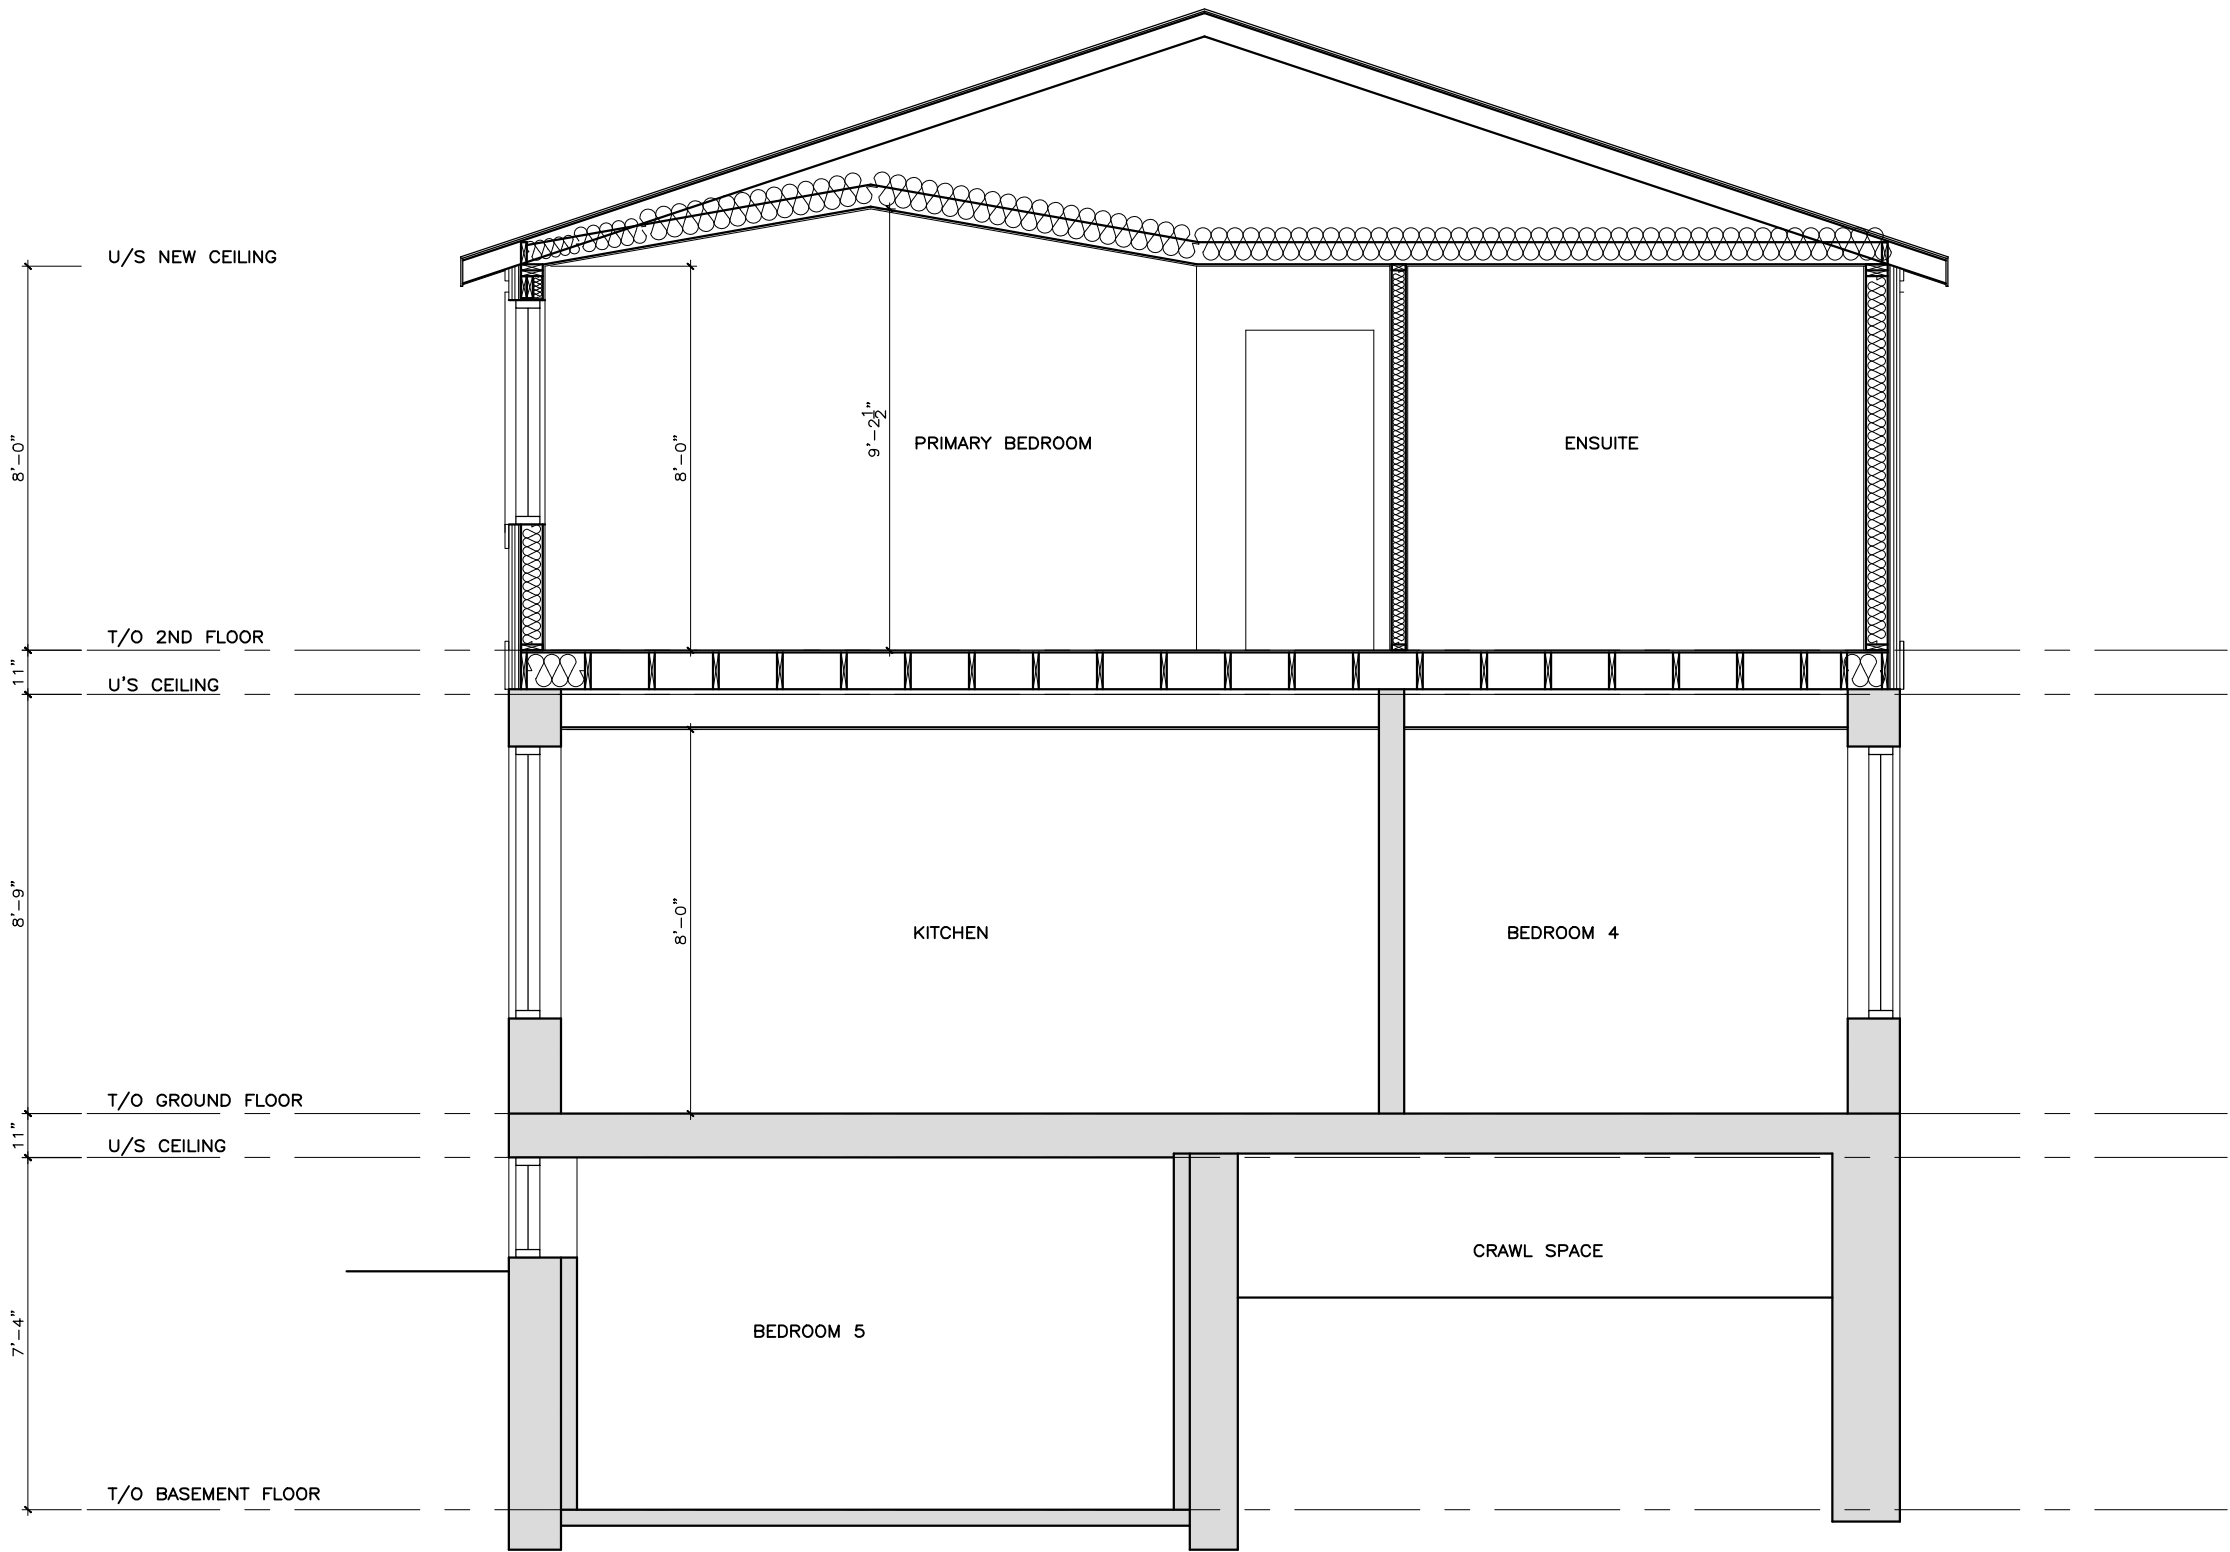

DESIGNS BY:

Mark Hofstee

I review and take responsibility
for the design and am qualified
in the appropriate category as
an "other designer" under
sub-section 3.2.5 of the
Ontario Building Code

BCIN: 25513

OWNER'S GENERAL CONTRACTOR
TO VERIFY ALL DIMENSIONS ON SITE
PRIOR TO THE COMMENCEMENT OF
THE WORK. REPORT ANY
DISCREPANCIES TO THE DESIGNER.
DO NOT SCALE DRAWINGS.

PROJECT:

McGILLIVRAY STAHL
RESIDENCE -
2ND FLR. ADDITION

107 ONTARIO ST.
GUELPH, ON

DRAWING TITLE:

PROPOSED
SECTION

DATE: 06.FEB.2023

DRAWN BY: TD

STATUS: ISSUED FOR REVIEW

SCALE:

AS NOTED

A10

