



ALICE STREET

CUT EXISTING CURB TO SUIT NEW DRIVEWAY.
SITE CONFIRM AND COORDINATE WITH CIVIL
DRAWINGS.

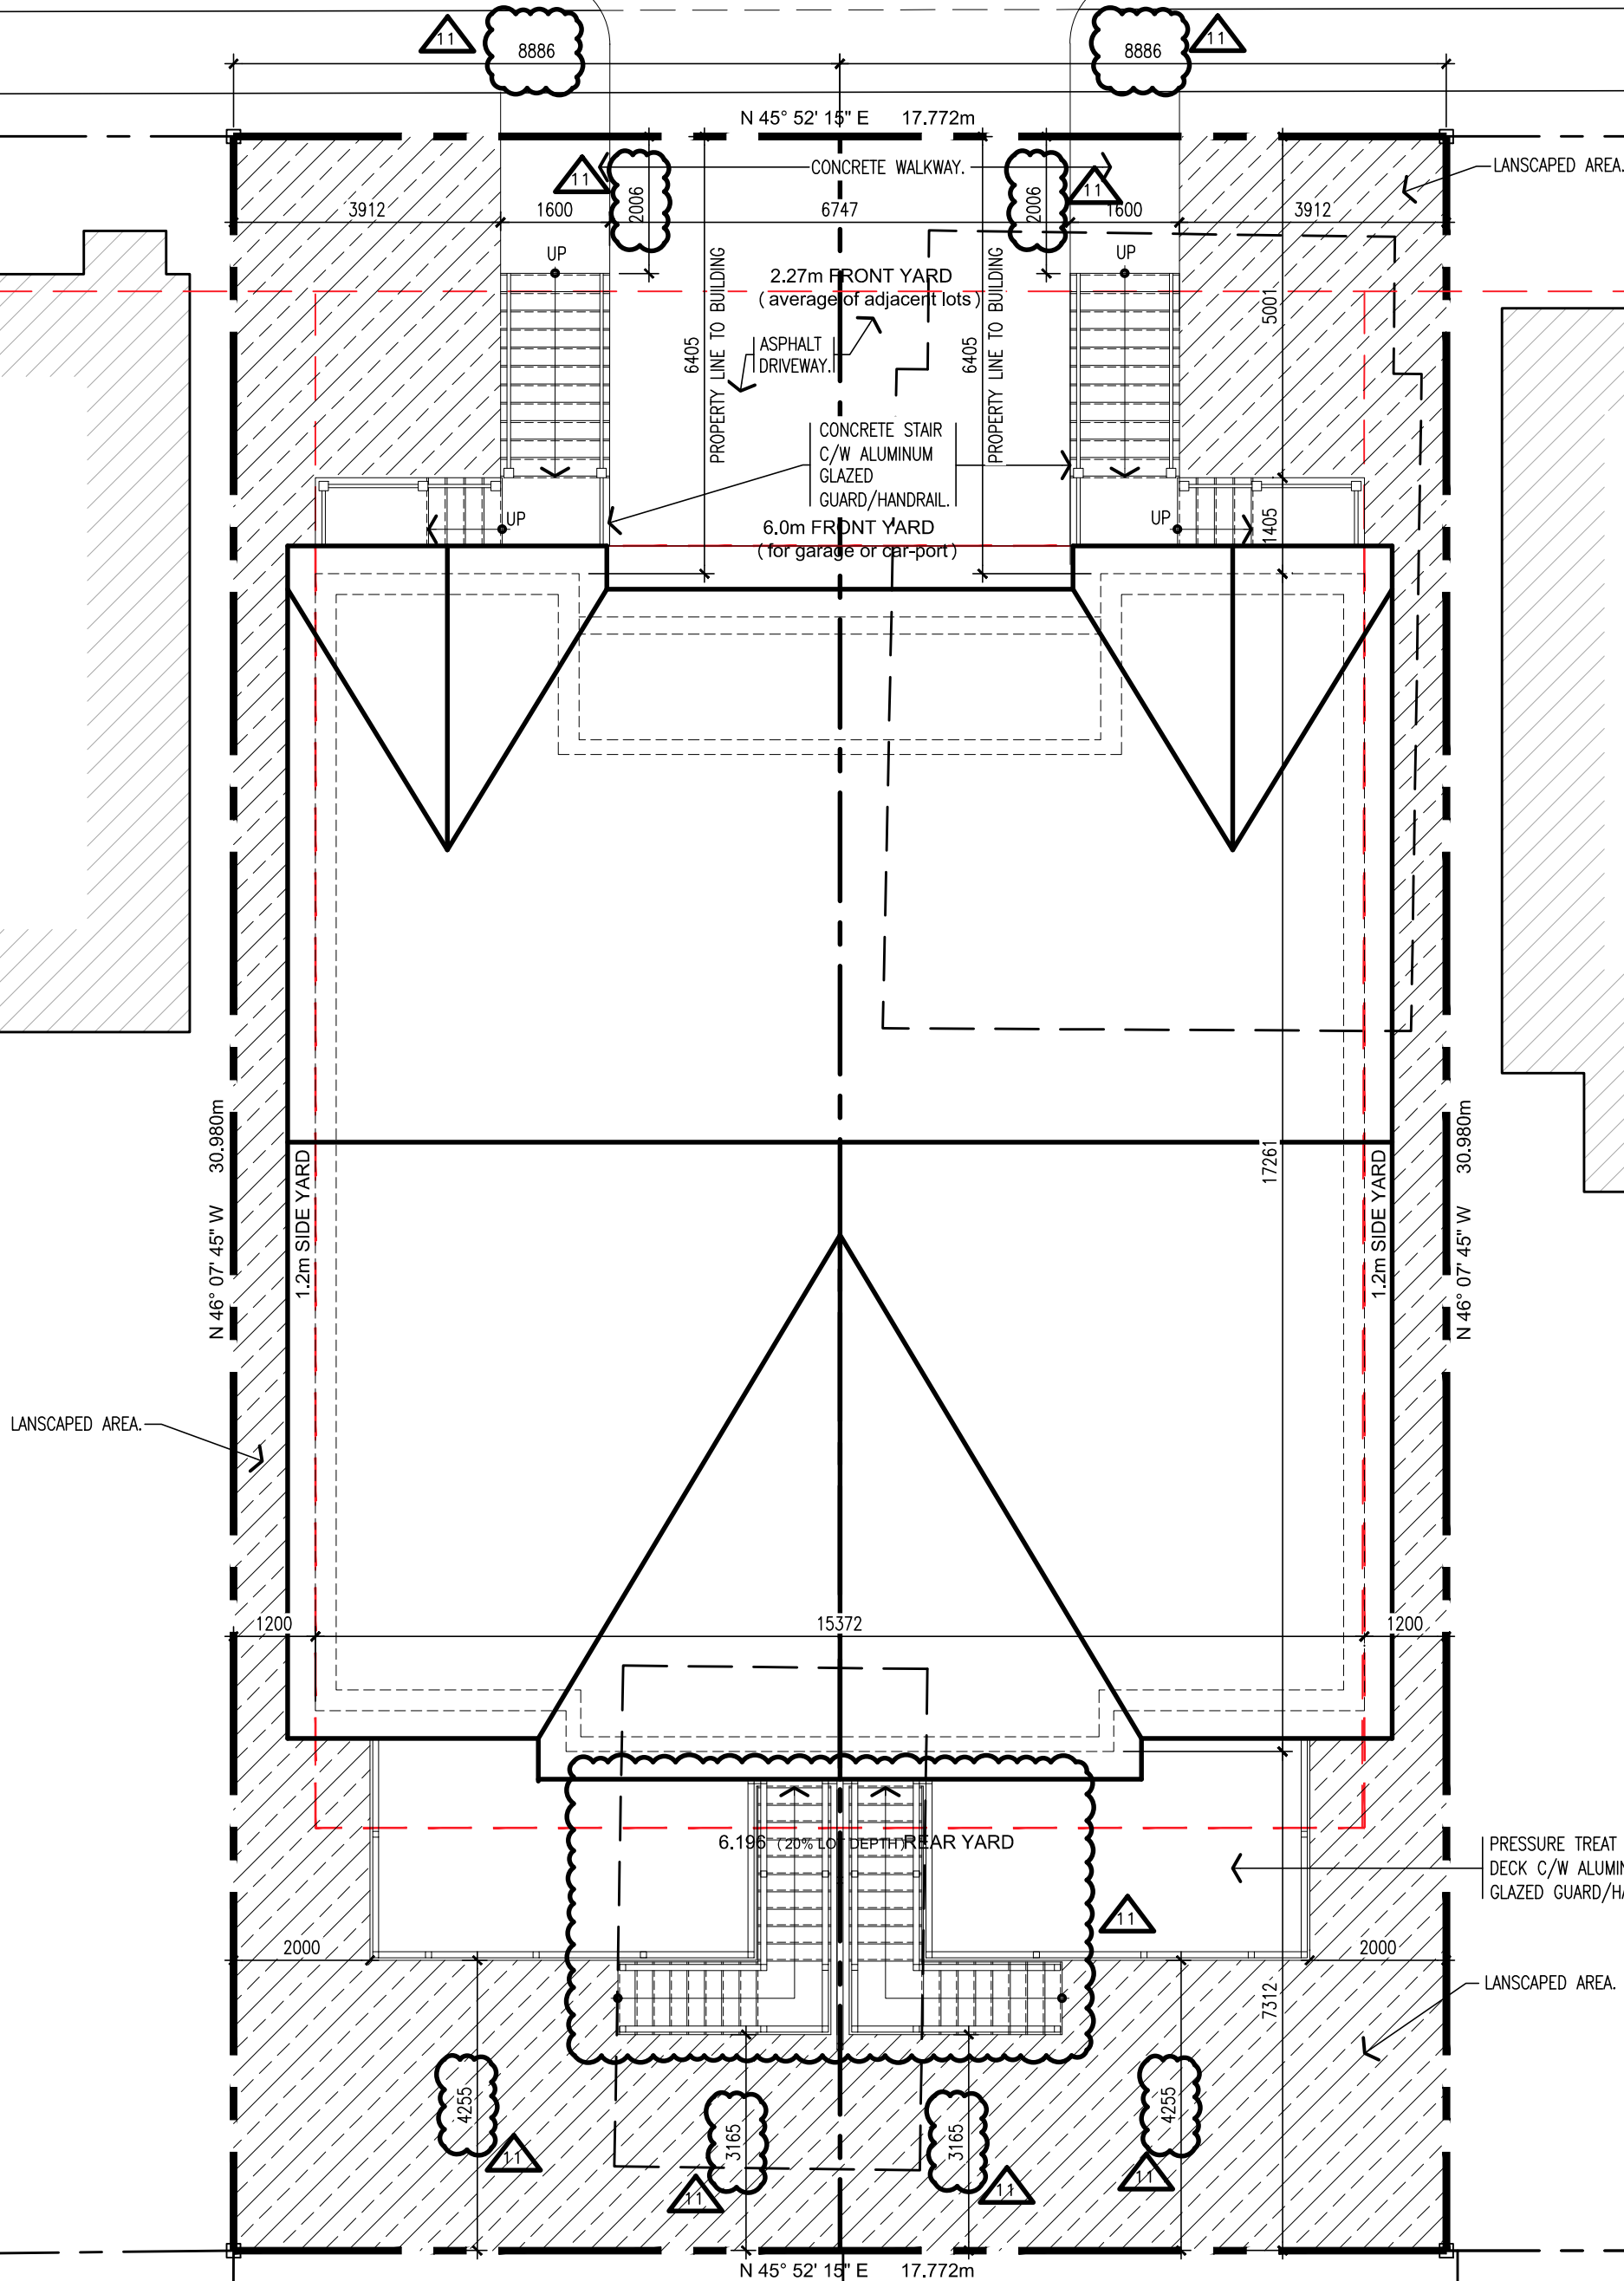

KEY PLAN

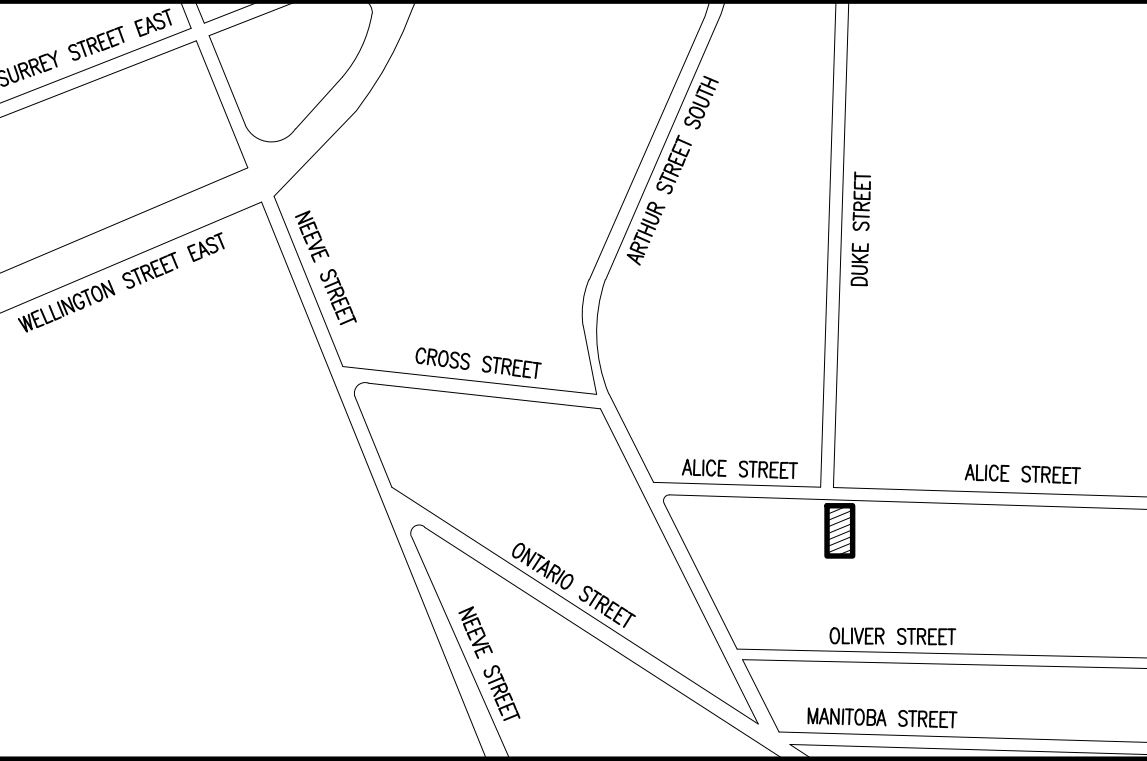

ROOF & FLOOR PLAN GENERAL NOTES

WINDOWS & EXT. DOORS NOTE:
BUILDER/HOMEOWNER TO VERIFY ALL WINDOW & EXTERIOR DOOR STYLES/SIZES PRIOR TO ORDERING. WHERE TRANSOMS ARE NOTED ON PLAN - THE SIZE IS IN ADDITION TO THE WINDOW SIZE ALREADY NOTED.
UNLESS OTHERWISE NOTED, TOP OF ALL WINDOWS TO BE FRAMED AT 7'-0" MAX. WITH TRANSOM LOCATED ABOVE.
CONFIRM THIS HEIGHT WITH TRUSS DWGS. (FASCIA DROP/HEEL HEIGHT)
PRE-ENGINEERED TRUSSES:
ROOF FRAMING/LAYOUT TO BE DESIGNED BY TRUSS MANUFACTURER. MANUFACTURER TO SUBMIT STAMPED ENGINEERED SHOP DRAWINGS TO CONTRACTOR/OWNER FOR APPROVAL. BY LOCAL AUTHORITIES. IF GIRDER TRUSS LOCATIONS ARE SHOWN ON THIS DRAWING, THEY ARE BASED ON ANTICIPATED PLACEMENT DESIGNED BY ROOF SUPPLIER.
GENERAL ELECTRICAL NOTES:
ALL ELECTRICAL TO CONFORM WITH (9.34) AND BE COMPLETED & INSPECTED AS PER THE ONTARIO ELECTRICAL SAFETY CODE (ESA). LOCATION AND TYPE OF ELECTRICAL OUTLETS, SWITCHES AND LIGHT FIXTURES ARE TO BE CONFIRMED BY HOME-OWNER & OR CONTRACTOR.
LVL MEMBERS & TRUSS JOIST:
SUPPLIERS OF ALL LVL MEMBERS AND TRUSS JOIST SYSTEMS TO PROVIDE ENGINEERED SHOP DRAWINGS. BJC architects + assoc. inc. IS NOT RESPONSIBLE FOR PRE-ENGINEERED PRODUCTS.
AS PER VENTILATION SYSTEMS) SEE O.B.C. 9.32.
DRYER EXHAUST FANS TO CONFORM WITH PART 6.
END BEARINGS:
ALL WOOD & STEEL BEAMS SHALL HAVE EVEN & LEVEL BEARING AND SHALL NOT HAVE LESS THAN 3-1/2" OF BEARING AT END OF SUPPORTS AS PER (9.23.6.1)
ALL FLOOR JOISTS SHALL HAVE NO LESS THAN 1-1/2" MIN. LENGTH FOR END BEARING, EXCEPT WHERE SUPPORTED ON RIBBON BOARD (9.23.9.1 (1))
ALL WOOD UNITS WITH SPANS LESS THAN 9'-8" REQUIRE MIN. 1-1/2" BEARING AT EACH END, EXCEPT WHERE SPANS ARE GREATER THAN 9'-10" MIN. BEARING SHALL BE 3" (9.23.12.3)).
POINT LOADS:
POINT LOADS CREATED IN WALLS DUE TO GIRDER TRUSSES OR BEAMS ENDS ARE TO HAVE TRIPLE STUDS WHICH ARE TO BE CARRIED DOWN THE FOUNDATION WALL.
FORCED ENTRY WINDOWS:
WINDOWS WITHIN 6'-7' OF THE ADJACENT GROUND LEVEL THAT SERVE THE INTERIOR OF THE DWELLING UNIT SHALL BE RESISTANT TO FORCED ENTRY 99.7.6.1).
LIGHTING OUTLETS:
-PROVIDE EXTERIOR LIGHTS AT ALL EXITS, (9.34.2.1)
-EVERY STAIRWAY SHALL BE LIGHTED AND CONTROLLED WITH A 3-WAY SWITCH FOR STAIRWAYS WITH MORE THAN 4 RISERS IN DWELLING UNITS (9.34.2.3)
STRUCTURAL DESIGN CRITERIA:
AS PER OBC 9.4.2.2 & SB-1
S_s = 1 IN 50 YR. GROUND SNOW LOAD IN KPA PER SB-1
S_r = 1 IN 50 YR. RAIN LOAD IN KPA PER SB-1
C_b = BASIC SNOW LOAD FACTOR OF 0.55 FOR
ROOF SPANS IN EXCESS OF 4.3M (14' - 1").
BASED ON NEAREST LOCATION: GUELPH
(a) SPECIFIED SNOW LOADS FOR AREA: 0.55(C_b) X 1.9 (S_a) + 0.4 (S_r) = 1.45 KPA.
IN NO CIRCUMSTANCE SHOULD THE SPECIFIED SNOW LOAD BE LESS THAN 1 KPA.
WOOD & STEEL UNITS/HEADERS:
ALL UNITS SUPPORTING TRUSS SPANS THAT EXCEED THE ALLOWED 32' - 1" SUPPORTED TRUSS LENGTH ARE TO BE PRE-ENGINEERED LVL HEADERS. (9.23.12)
ALL UNITS TO BE GRADE 2 BPF (2) 2X10' UNLESS OTHERWISE NOTED. IF WINDOW SIZES ARE CHANGED, PLEASE REFER TO SHEET A-301 FOR WOOD UNITS. CHARTS. ALL UNITS UNDER OPENINGS CARRYING POINT LOADS ARE TO BE PRE-ENGINEERED.
REFER TO SHEET A-301 FOR STEEL UNTEL CHARTS.

NOTES FOR HEATING EQUIPMENT

ZONE 1, SB-12 COMPLIANCE PACKAGE (A2) FOR HEATING EQUIPMENT
AS PER TABLE 3.1.1.2.A (P)
• SUBSTITUTE METHODS ARE ALLOWED PROVIDED THEY MEET MIN. EFFECTIVE R-VALUE
-CEILING WITH ATTIC SPACE - MIN. R60
-CEILING WITHOUT ATTIC SPACE - MIN. R31
-EXPOSED FLOOR JOISTS - MIN. R31
-WALLS ABOVE GRADE - MIN. R19 & R5c1
GENERAL PLUMBING NOTES:
ALL PLUMBING TO BE COMPLETED AS PER (9.31 & PART 1).
-PRESSURE BALANCED OR THERMOSTATICALLY CONTROLLED MIXING VALVES SHALL BE PROVIDED FOR ALL SHOWER UNITS. (PART 7.6.5.2)
-PRESSURE BALANCED OR THERMOSTATICALLY CONTROLLED MIXING VALVES SHALL BE PROVIDED FOR ALL FAUCETS OR WATER HEATER SOURCE.
-BASEMENT WALLS - R12 + R10c1
-WINDOWS & SLIDING GLASS DR. - MAX. 0.28U/25 ENERGY RATING
-SKYLIGHTS - MAX 0.49U
-SPACE HEATING EQUIP - MIN. 90% AFUE
-HRV EFFICIENCY MIN. 75% SRE
-DOMESTIC HOT WATER HEATER - MIN. 0.7 EF

NOTE:
This drawing and all associated documentation are the confidential property of BJC architects + assoc. inc. and must be returned upon request. Any duplication, reuse, revision and/or distribution in part or whole without the prior written authorization of BJC architects + assoc. inc. is strictly prohibited. Each contractor will check and verify all dimensions and report all errors and omissions to the design professional whose seal is affixed to this drawing. Do not scale this drawing.
The information and material herein reflect the best judgement of BJC architects + assoc. inc., in light of the information available to them at the time of preparation of these documents. Any use which a third party makes of these documents, or any reliance on or decisions to be made based on them, is the sole responsibility of such third party. BJC architects + assoc. inc. accepts no responsibility for damages, if any, suffered by any third party as a result of decisions made or actions based on these documents © BJC architects + assoc. inc. 2025.

ISSUED FOR MINOR VARIANCE	2025.03.05
ISSUED FOR GRCA APPROVAL	2025.02.18
ISSUED FOR CONSTRUCTION	2024.12.03
RE-ISSUED FOR BUILDING PERMIT	2024.10.08
RE-ISSUED TO ADDRESS BUILDING PERMIT REVIEW COMMENTS	2024.09.09
RE-ISSUED FOR BUILDING PERMIT	2024.08.09
RE-ISSUED FOR CLIENT PRICING	2024.08.08
ISSUED FOR BUILDING PERMIT	2024.07.29
REISSUED FOR CLIENT DESIGN CHANGE	2024.07.23
REISSUED FOR CLIENT PRICING	2024.06.07
ISSUED FOR CLIENT PRICING	2024.05.21

No.	REVISIONS	date
	scale 1:96	

	drawn	
	DE/RTM	
	last worked on	by
	2025.03.05	DE
	checked	
	BRJ	
	print date	
	2025.02.27	



client
MARIO & ANTHONY COTRONEO

25 ALICE STREET
GUELPH ONTARIO

project
PROPOSED SEMI-DETACHED DWELLING

25 ALICE STREET
GUELPH ONTARIO

drawing title
SITE PLAN

reference

project no. 22-115 client reference number

sheet no.

A-10107